

CERTIFICATION
 RPS Australia East Pty Ltd (ACN 140 292 762) certifies that the locations, surface and invert levels of the sewerage infrastructure on this plan have been surveyed in accordance with the Surveying Act 2003 and the Surveying Regulation 2003. This plan is a copy of the original and is not to be used for any other purpose, use or matter. The plan is presented without the assumption of a duty of care to any other person (other than the Client) (Third Party) and may not be relied on by Third Party.

IMPORTANT NOTE
 1. This plan was prepared for the sole purpose of the client for the specific purpose of recording the infrastructure for the Cairns Regional Council. This plan is a copy of the original and is not to be used for any other purpose, use or matter. The plan is presented without the assumption of a duty of care to any other person (other than the Client) (Third Party) and may not be relied on by Third Party.

2. RPS Australia East Pty Ltd will not be liable (in negligence or otherwise) for any direct or indirect loss, damage, liability or claim arising out of or incidental to:
 A. Third Party publishing, using or relying on the plan;
 B. RPS Australia East Pty Ltd relying on information provided to it by the Client or a Third Party where the information is incorrect, incomplete, inaccurate, out-of-date or unreasonable;
 C. any inaccuracies or other faults with information or data sourced from a Third Party;
 D. RPS Australia East Pty Ltd relying on surface indicators that are incorrect or inaccurate;
 E. the Client or any Third Party not verifying information in this plan where recommended by RPS Australia East Pty Ltd;
 F. lodgement of this plan with any local authority against the recommendation of RPS Australia East Pty Ltd;
 G. the accuracy, reliability, suitability or completeness of any approximations or estimates made or referred to by RPS Australia East Pty Ltd in this plan.

3. Without limiting paragraph 1 or 2 above, this plan may not be copied, distributed, or reproduced by any process unless this note is clearly displayed on the plan.


4. Scale shown is correct for the original plan and any copies of this plan should be verified by checking against the bar scale.

5. Type and size of mains, locations and levels of house connection branches and ends have been provided by the consulting contractor and have not been verified. Other information has been obtained from design and construction information [provided by Third Parties] and should be checked before use.

6. The positions of some services shown on this plan have been exaggerated for drawing clarity purposes. Dimensions shown take precedence over scaled position.

NOTES
 Level Datum: AHD
 Origin of Levels: PSM 71656
 RL 10.669
 Meridian: MGA Zone 55 GDA94
 Origin of Coordinates: PSM 150310
 E 357677.715
 N 8147025.192

On type E2 property connection branches Council will only have ownership from the sewer main to the subject property boundary.
 That part of the connection branch within the subject property is the responsibility of the property owner.

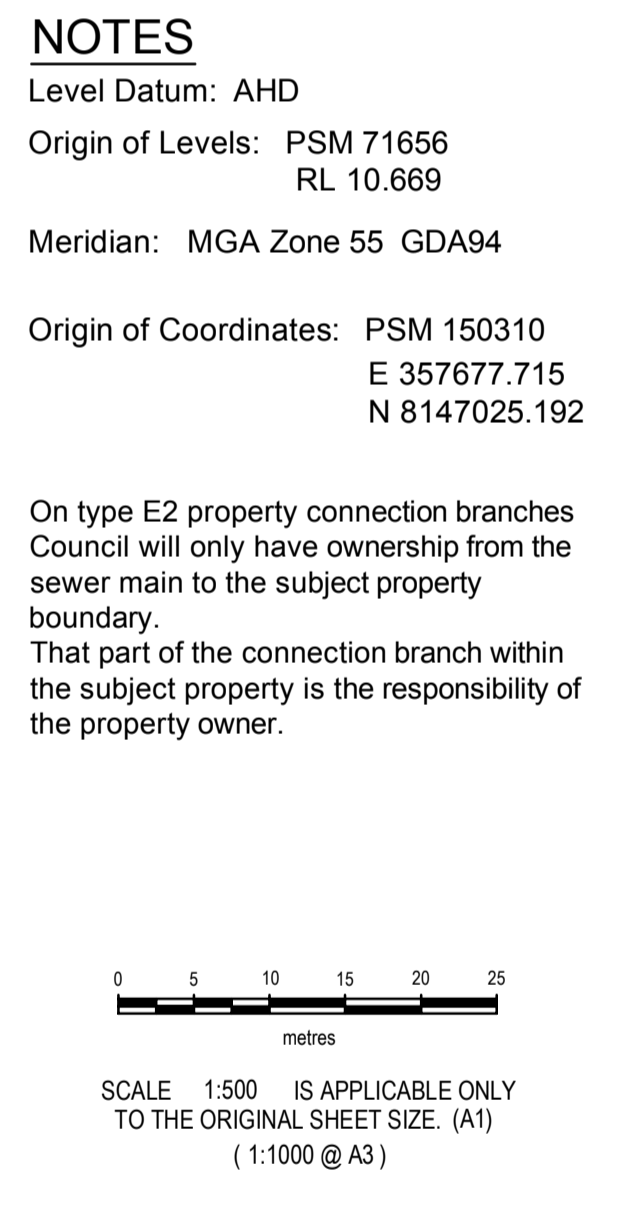

AMENDMENTS	
A: AMK: STAGES 2 & 4 ADDED.	
PROJECT MANAGER	SURVEYED
I Doust	CF
COMPILED	CAD REF
AMK	PR134089-30A.DWG
SHEET SIZE	PR134089 Overall As Constructed.mxd
A1	XR PR134089-27.DWG

RPS Australia East Pty Ltd
 ACN 140 292 762
 135 Abbott St
 PO Box 1949
 CAIRNS QLD 4870

T +61 7 4031 1336
 F +61 7 4031 2942
 W rpsgroup.com.au

ARGENTEA

STAGES 1 TO 4
AS-CONSTRUCTED
SEWERAGE
SHEET 2 OF 2

SCALE	DATE	DRAWING NO.	ISSUE
1:500	5/11/2018	PR134089-31 A	